

## CHANGE ORDER REQUEST

To:

No. COR 059R-2

Date

Project # 180046

Project Name Tolleson Union High School No 7

Project Manager Connor Lewis

### Scope Description

### Additional Days

Provide additional trenching and conduit to relocate existing Communications Utilities in the Right of Way along Avondale Blvd as required by regulatory agencies (CenturyLink) adjacent to the school's property.

| Job Code  | Cost Code | Description                                       | Amount   |
|-----------|-----------|---|----------|
| 180046-10 | 33100     | Cactus - Dig Trench for Relocation of CenturyLink | 8,832.00 |
| 180046-10 | 33300     | Badger - Pot hole existing utilities              | 9,200.00 |
| 180046-10 | 70100     | Liability Insurance                               | 180.32   |
| 180046-10 | 70400     | Builders Risk Insurance                           | 63.74    |
| 180046-10 | 70500     | Payment & Performance Bonds                       | 201.04   |
| 180046-10 | 79999     | Contractor Fee                                    | 1,005.16 |
| 180046-10 | 70600     | Gross Receipts Tax                                | 1,114.38 |

**Change Order Request Total** \$ 20,596.64

### NOTE:

Unless clarified above, CHASSE Building Team reserves the right to evaluate and/or revise the scheduled completion date and review general conditions for the project based on the cumulative impact of this and other changes in the future.

CONTRACTOR

OWNER

ARCHITECT

**CHASSE Building Team**

**Submitted By:**

**Approved By:**

**Approved By:**

Connor Lewis

cc:

Date:



Date:







© Copyright, YYYY, HILGARTWILSON, LLC - This plan document set is the sole property of HILGARTWILSON, LLC. No alterations to these plans, other than adding "as-built" information, are allowed by anyone other than authorized HILGARTWILSON, LLC employees.

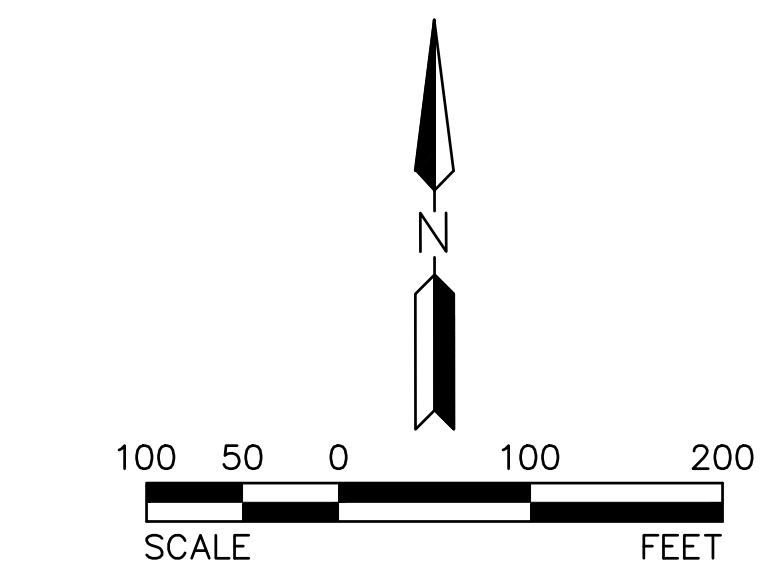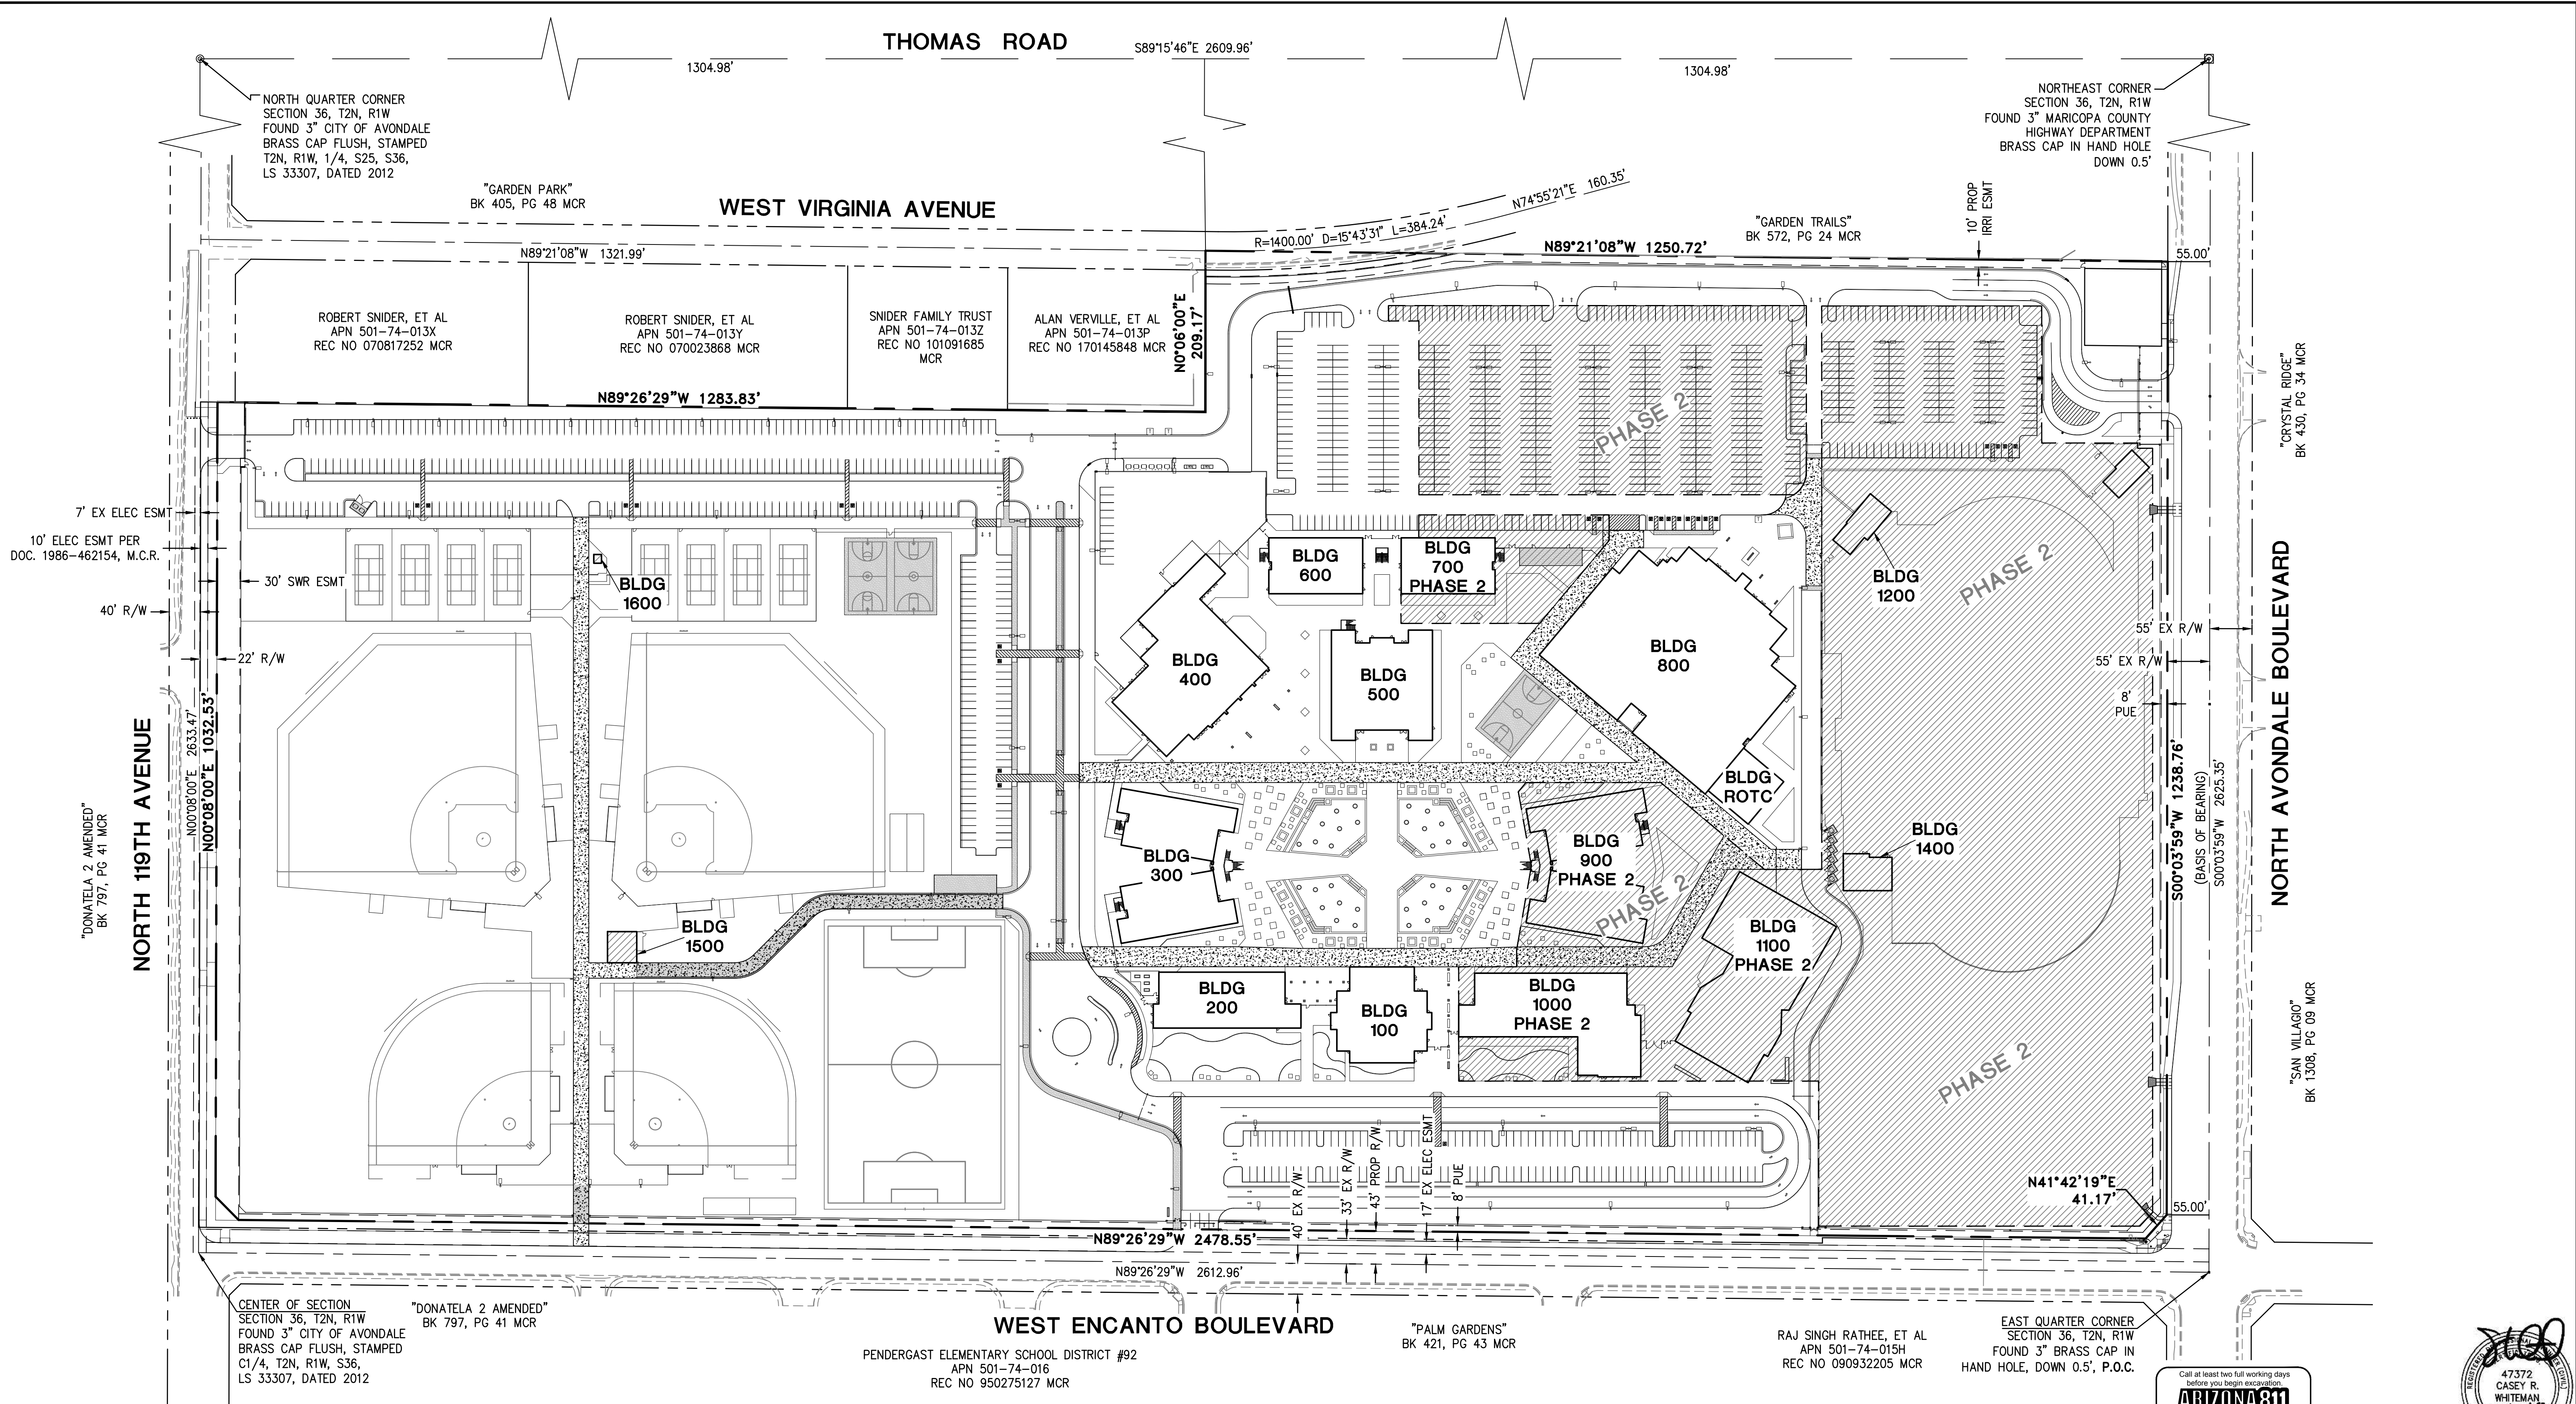

FOR REFERENCE ONLY

Call at least two full working days before you begin excavation

**ARIZONA 811**

Arizona Blue State, Inc.  
Dial 8-1-1 or 1-800-STAKE-IT (1-800-782-5348)  
In Maricopa County, (602) 253-1100

**47372**  
CASEY R.  
WHITEMAN  
Surveyor  
ARIZONA U.S.A.  
Expires 03/31/2020

**TOLLESON HIGH SCHOOL #7**  
11620 WEST ENCANTO BLVD  
AVONDALE, ARIZONA

**OVERALL CIVIL SITE PLAN**

PROJ. NO. 1959

DATE: AUGUST 2018

SCALE: 1" = 100'

DESIGNED: JW

DRAWN: CM

APPROVED: CW

REV.

**HILGARTWILSON**

DWG. NO.  
**C1.0**  
SHT. X OF X

U:\1900\1959\ENGR\PLANS\CD\S\Onsite\1959 - C1.0 SITE OVERALL.dwg 8/23/2018 11:01 AM

ENG-18-0171

## Proposed Irrigation Pipe

**Copper Solution:** In Trench at Pit location and near HH location the 600pr cable can be spliced and splice can be buried.

**Fiber Solution:** In Trench place Innerduct from pit to HH. At night, cut and pull fiber back to HH, then place new fiber through new Innerduct to the new HH. This will provide the necessary slack for splicing in the HH.

Place HH over  
existing Cables  
North of Conflict

## Dig Trench between Pit and HH.

# Dig Pit to expose cables South of Conflict

## Existing CenturyLink Cables